
Regulated Design Record								
Project Address: 387-389 Illawarra Road, Marrickville								
Proje	ct Title:	FRESH HOPE						
Cons	ent No: -		Body Corporate Reg No:					
Draw	ing Title: M	S - Ground Floor Layout	Drawing No: N	Л 100				
Rev	Date	Description	DP Full Name	Reg No				
I	03.07.23	FOR CONSTRUCTION	Sep Aghdaei	DEP0002416				



25/10/23 AS INSTALLED					
I	03/07/23	T/E DUCT REVISED	QV		
Н	19/01/23	HYDRAULIC OVERLAID UPDATE	QV		
G	30/09/22	REVISED T/E DUCTWORK	QV		
F	04/08/22	REVISED PUMP RM AIR EXHAUST DUCTWORK	QV		
Ε	13/07/22	REVISED PUMP RM AIR INTAKE LOCATION	QV		
D	06/07/22	GENERAL UPDATES	QV		
С	16/06/22	ELECTRICAL OVERLAID UPDATE	QV		
В	17/05/22	REVISED FOR APPROVAL	QV		
Α	02/05/22	FOR APPROVAL	QV		
Rev	Date	Description	Ву		

Level 2 490 Crown Street Surry Hill NSW 2010 **T** 61 2 9380 9911 www.hyecorp.com.au

Architect:

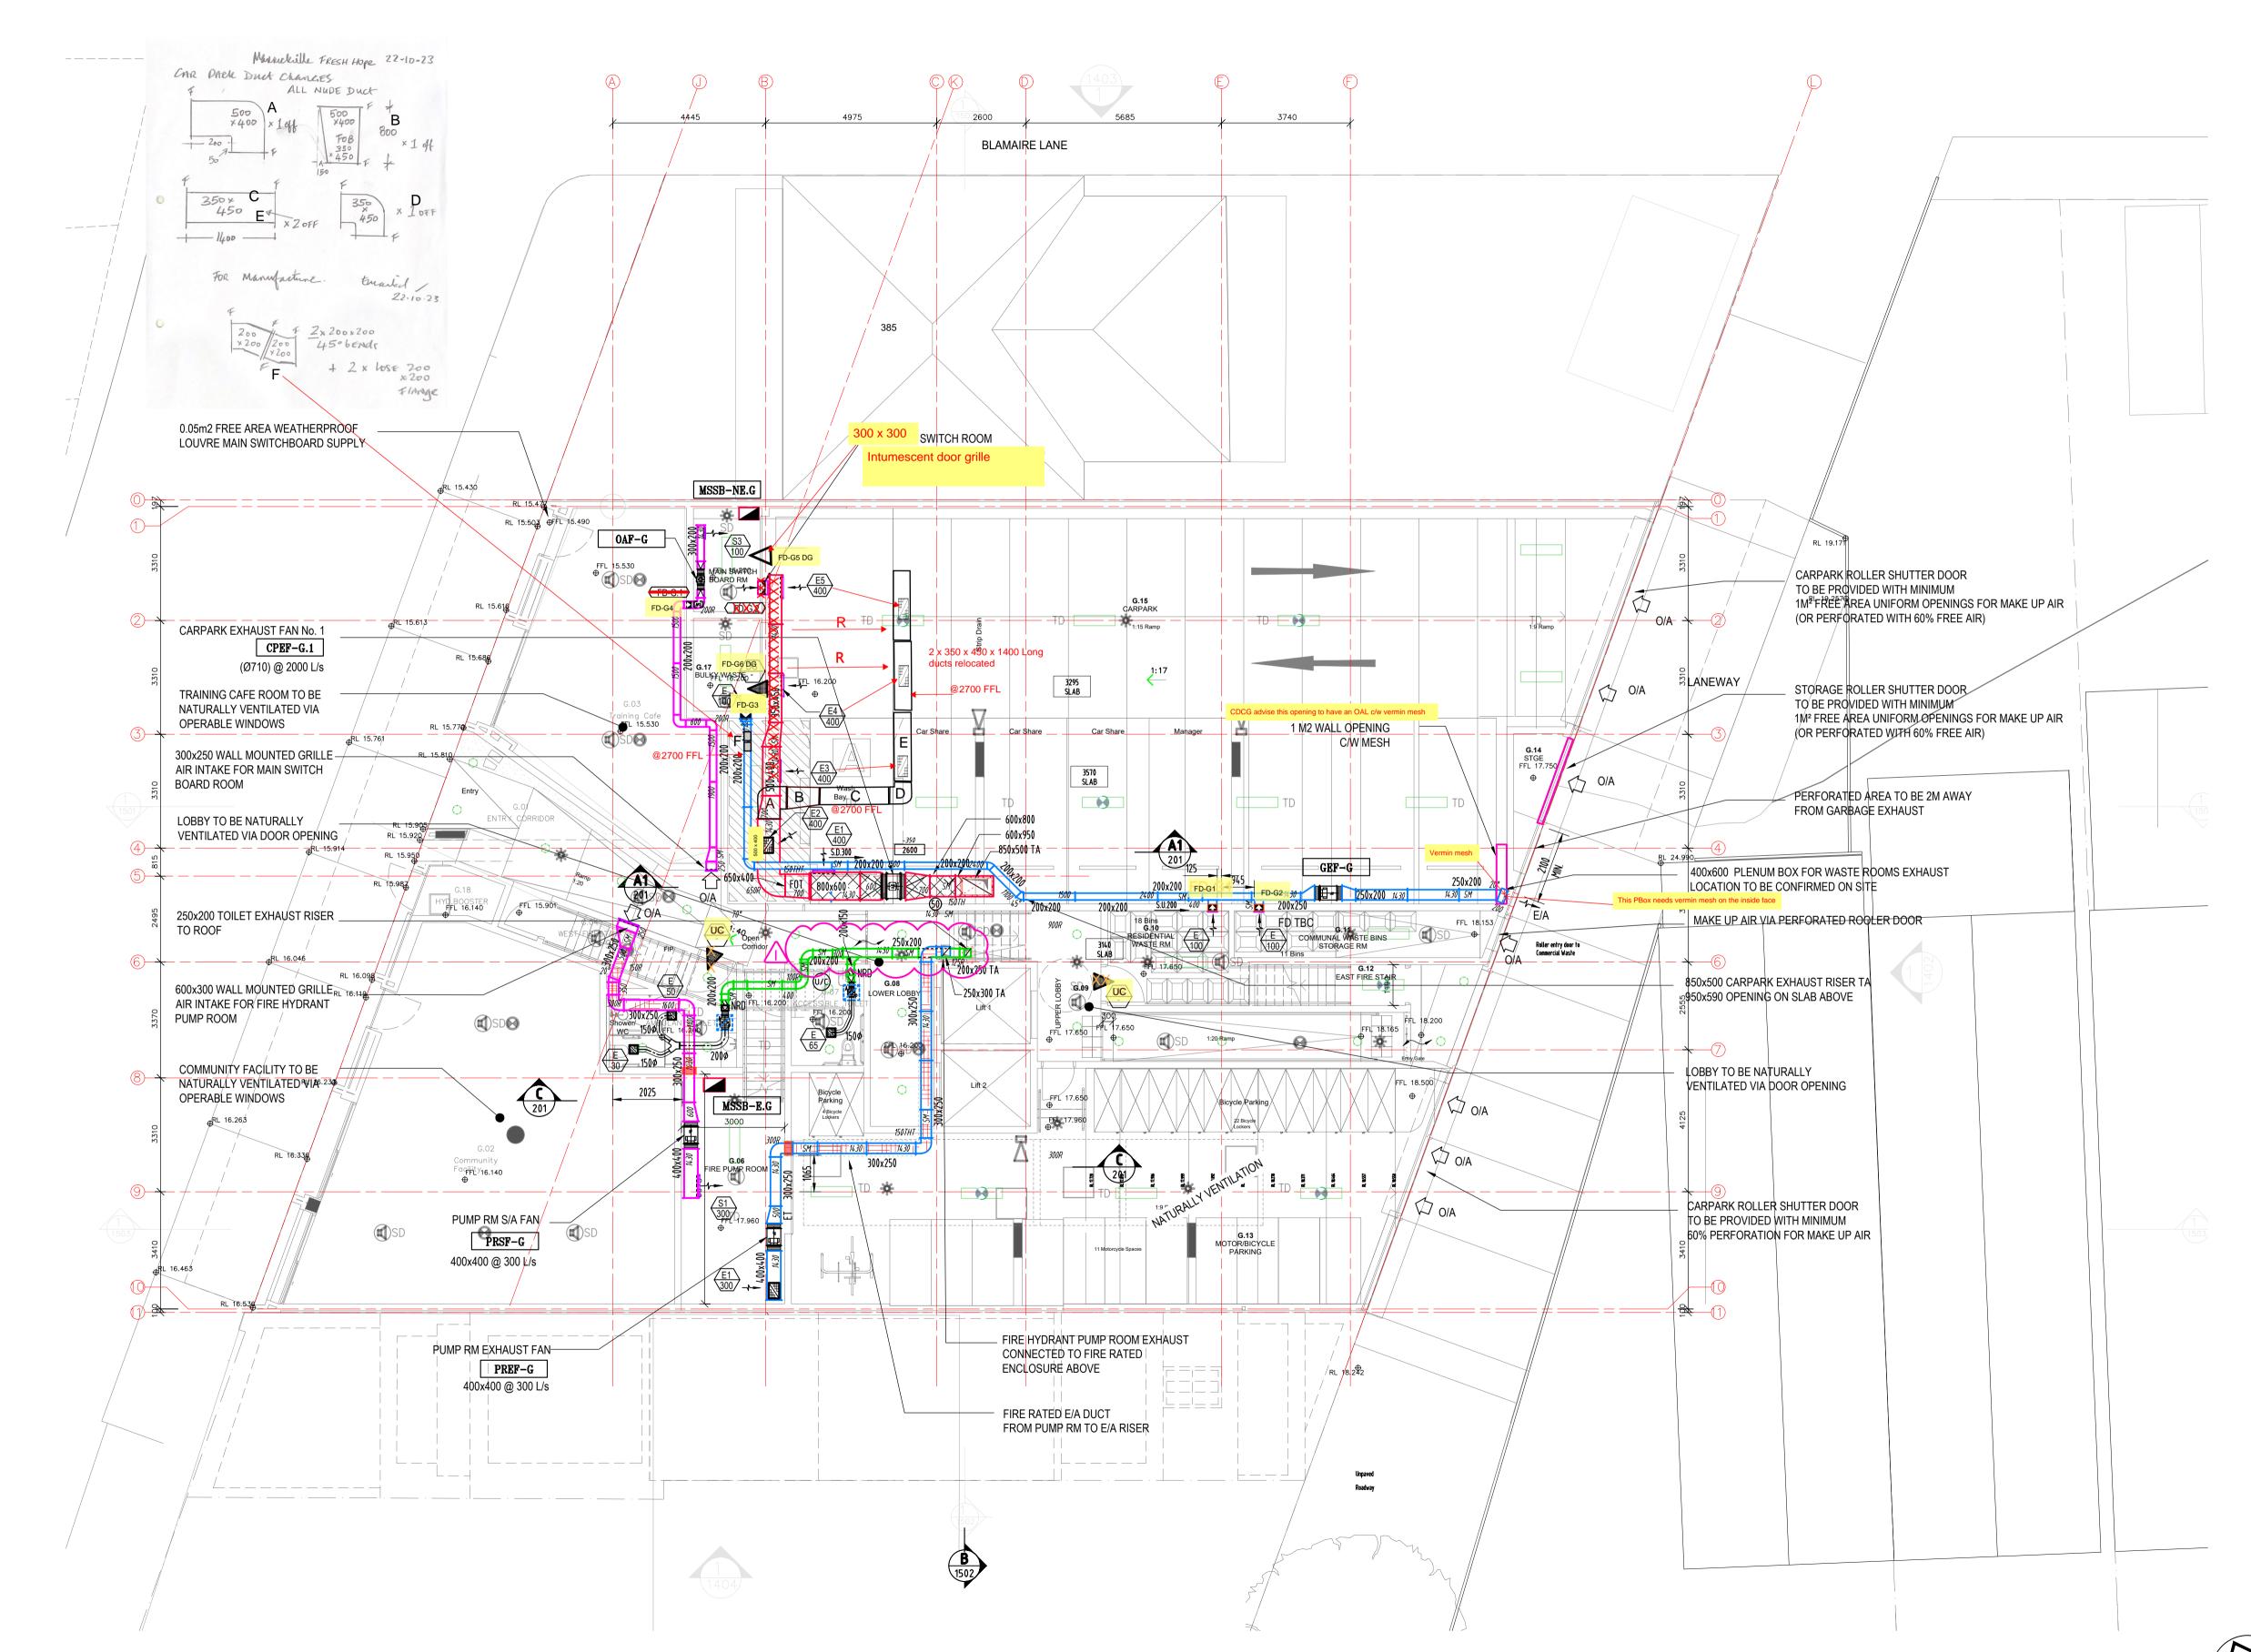

BROADAIR

Suite 253, Level 5, 7-11 The Avenue HURSTVILLE, NSW 2220 Email: admin@broadair.com.au

Tel: (02) 9131 4701 Fax: (02) 9789 6888

Fresh Hope 387-389 Illawarra Road, Marrickville

Drawing Title: MECHANICAL SERVICES Ground Floor Layout

0.00	· · · · · ·	11133(65)
PROJECT NO: J133	CHECKED BY: S.A.	SCALE: 1:100@A1
QV	S.A.	02/05/22
DRAWN	APPROVED	DATE:
	QV PROJECT NO:	QV S.A. PROJECT NO: CHECKED BY: